
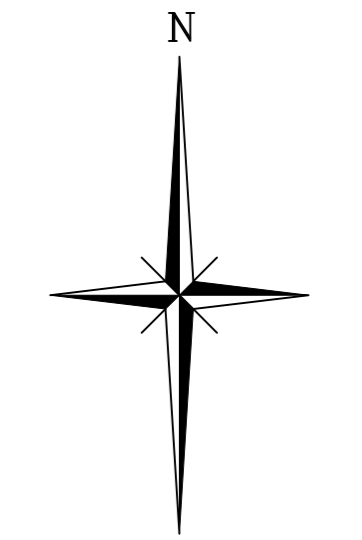


This drawing is to be checked against all other relevant drawings including those by specialist. Copyright of Henry Mein Partnership DO NOT SCALE

Revision	Date	By	Chkd	No
Various plots revised due to increase in party wall.	24/04/12	JEB	NH	A
House types renamed.	15/06/12	JEB	NH	B
Drive finishes added.	07/12/12	JEB	NH	C
Plot substitutions added.	11/06/13	JEB	NH	D
All garage footprints revised.	04/07/13	JEB	NH	E
Sub station added.	24/07/13	JEB	NH	F
Northern boundary revised.	31/07/13	JEB	NH	G
Plots 131 & 132 revised.	08/10/13	JEB	NH	H
Parking revised to plots 206 - 210.	14/10/13	JEB	NH	J
Additional survey info plotted adjacent plots 11/12, and plot boundaries revised to suit.	04/11/13	JEB	NH	K
Plots 154 to 158 reinstated. Double garage for plot 22.	30/07/14	JEB	NH	L
Woodcote and Westminster labelling revised.	30/10/14	JEB	NH	M
Plot 154 revised to Rollstone.	03/12/14	JEB	DSJ	N
Boundary wall to plot 37 revised.	08/09/15	JEB	DBJ	P
Boundary and access revised to plots 154 & 155.	17/12/15	JEB	DBJ	Q
Additional parking spaces annotated.	19/04/16	JEB	DBJ	R
Plot 1a added.	22/05/16	JEB	DBJ	S
Plots 68 and 70 revised to Hulland.	16/09/16	JEB	T	U
Rear boundary to plots 138 and 139 shown as built.	24/10/16	JEB	V	W
Garage to plot 68 repositioned.				
Beeley and Hassop indicated.	08/11/16	JEB	V	X
Road layout updated.	31/01/17	JEB	V	Y

Key	House Type	Bed	sq ft	No
A	Adernbrook	30/50	897	4
Al	Alone	30/40	828	7
Aw	Alone Special	30/40	895	2
Bs	Beeley	30/50	1057	6
B	Belfort	29/40	793	4
Bs	Broomwater	30/40	924	3
W	Woodcote	29/40	667	10
W	Westminster	29/40	794	6
Ba	Barnsbury	40/50	1057	22
Bs	Baywater	30/50	1057	2
Cl	Clarendon A	40/50	1043	2
E	Elmstead	40/50	1043	2
Ha	Hatfield	40/50	1273	3
Hu	Hulling	30/50	1057	3
Hu	Hulland	40/50	1273	3
Cl	Clarendon B	40/50	1043	2
La	Lynchfield A	30/50	973	12
La	Lynchfield C	30/50	983	6
Ra	Rollstone	40/70	1403	16
Do	Dove	50/50	2073	5
Ta	Tarleton	30/50	852	2
Ox	Oxley	40/50	1514	5
Vs	Veseyington	40/70	1700	4
Ke	Kensington	50/50	2237	4
S	Sudbury	50/50	2237	4
Bv	Balverstone	50/50	2282	5
Mw	Milton Variation	30/40	845	1
	Self Build Plots			12
	total housing			178

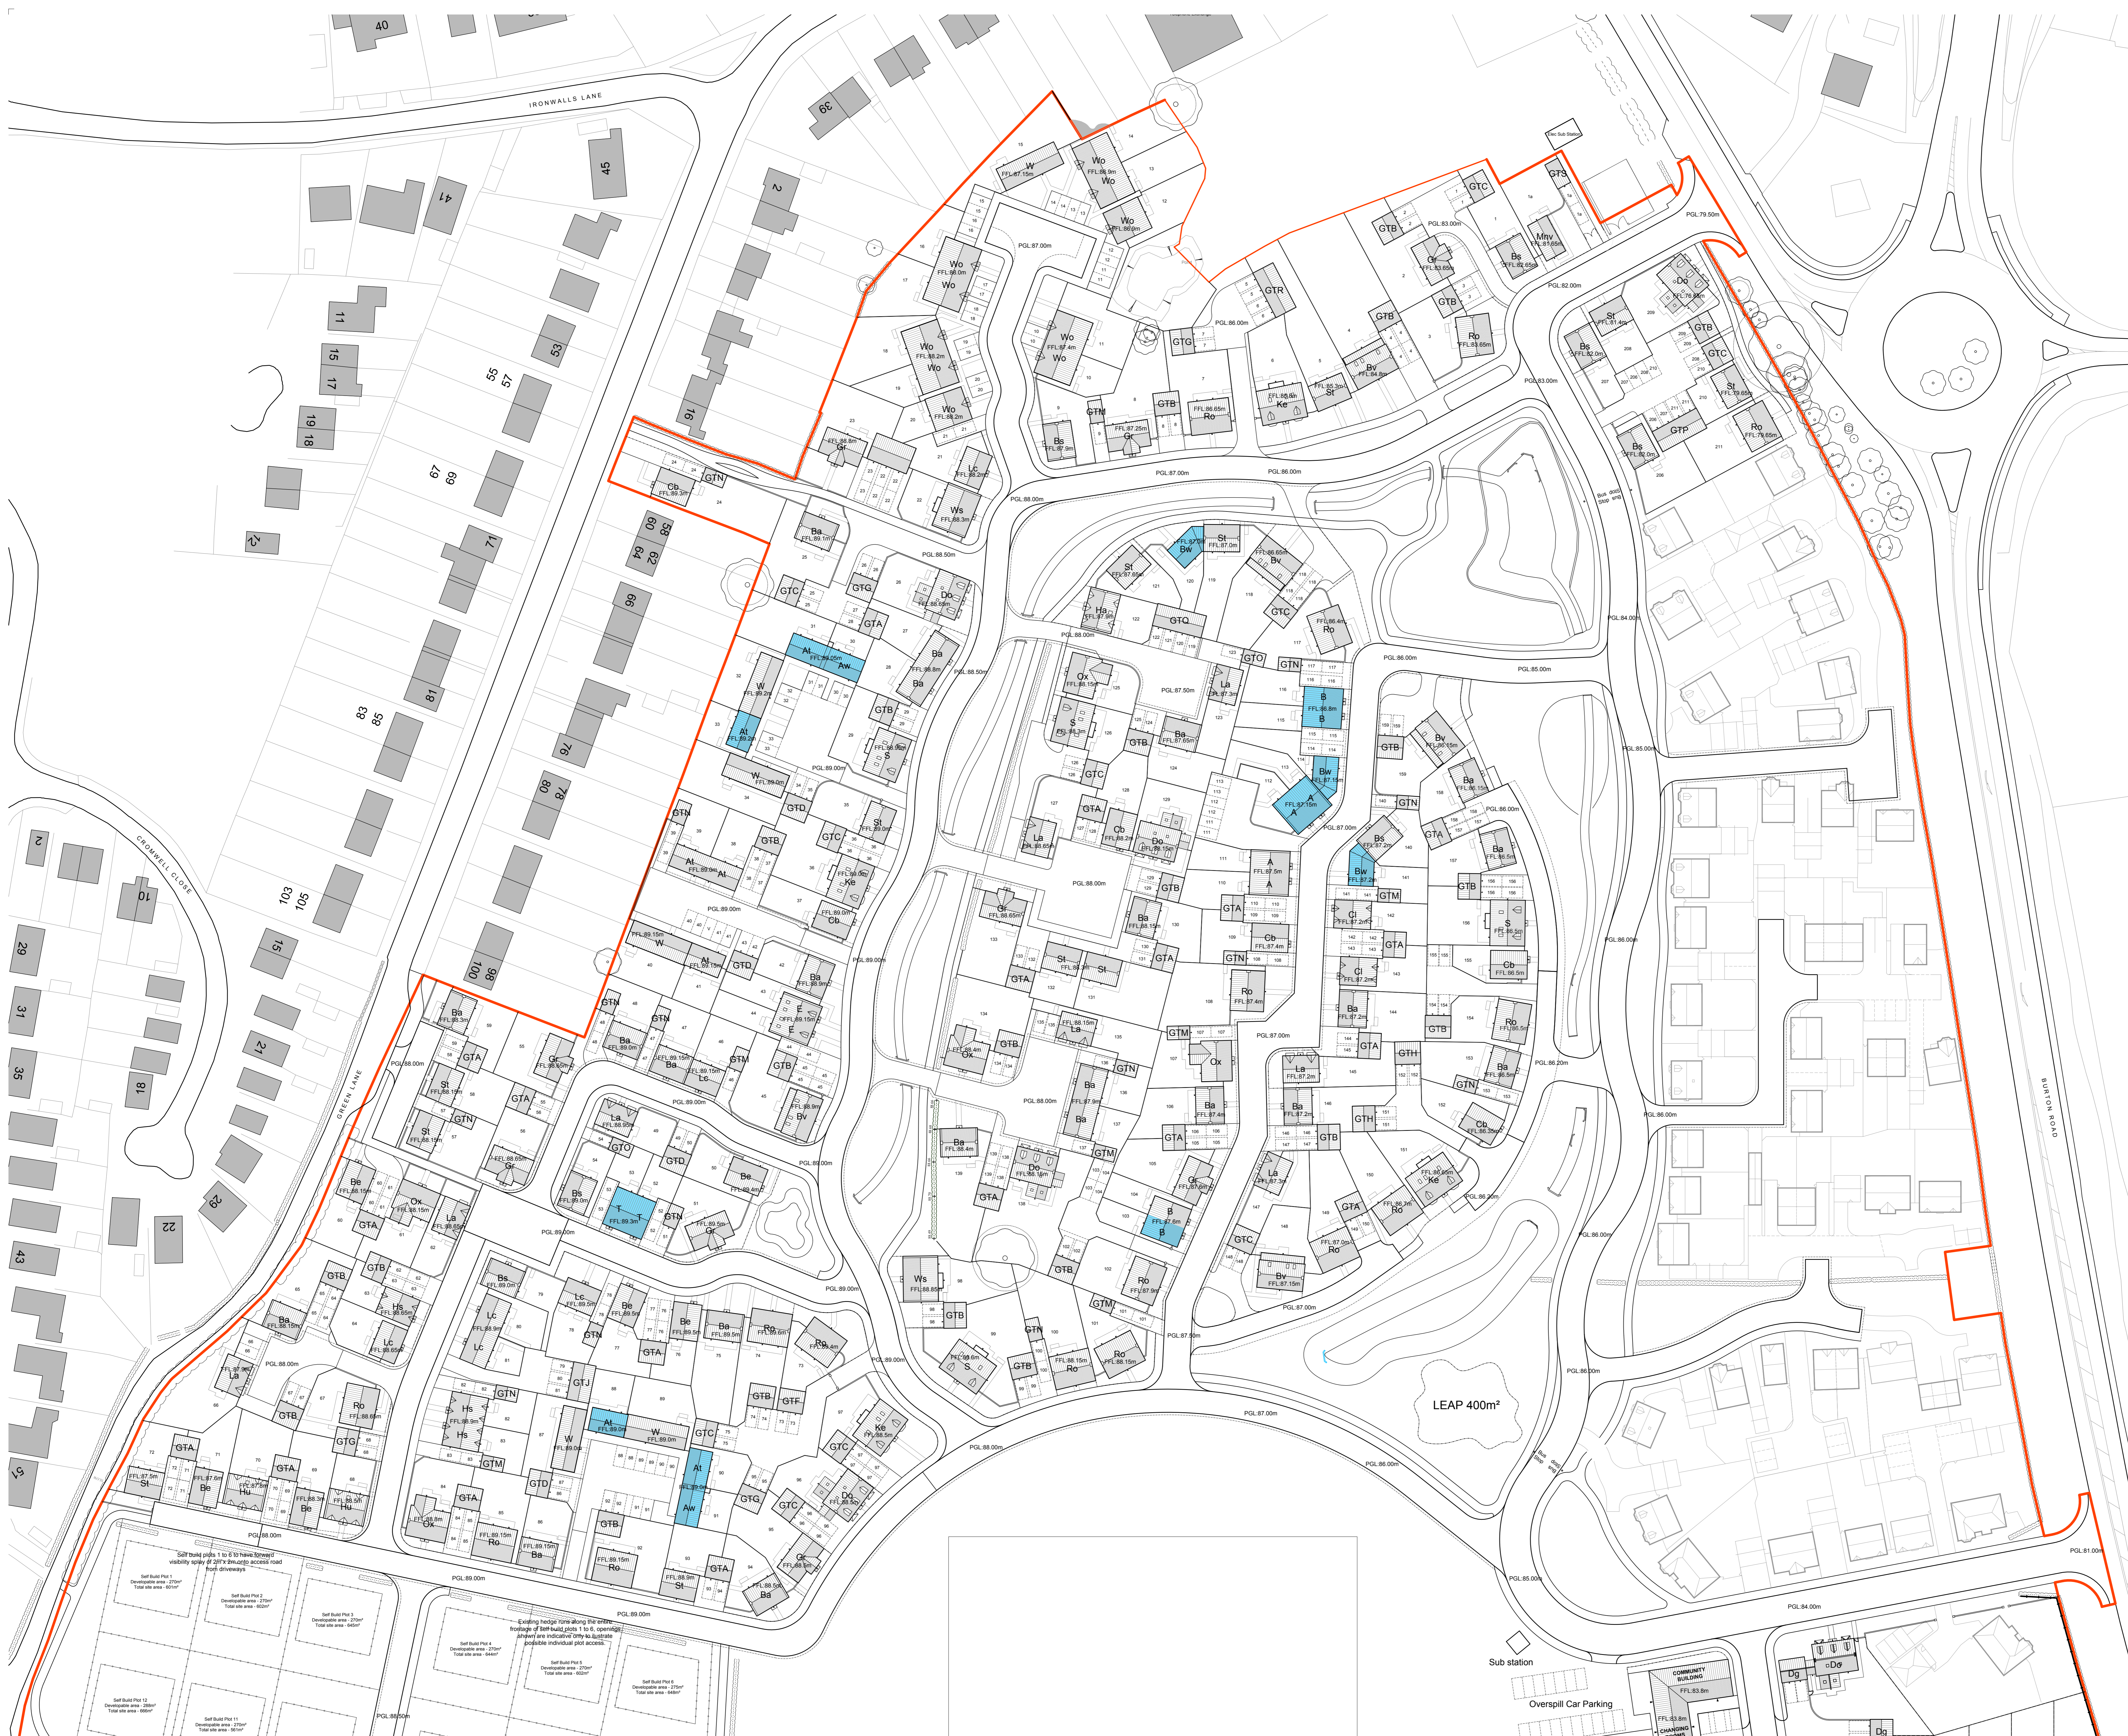

Peveril Homes Ltd
 Mixed Use Development
 Burton Road
 Tutbury

Site Plan

1:500 @ A0 February 2012 6640/C/01 W
 Drawn By: JEB Checked By: NH

Henry Mein Partnership
 Architects

CONSTRUCTION

12 Clarendon Street Nottingham NG1 5AQ t: 0115 9470065 f: 0115 924136 e: info@henrymein.co.uk www.henrymein.co.uk